


PLANS FOR  
 PAVING, GRADING, DRAINAGE, WATER & SEWERAGE IMPROVEMENTS

FOR  
 "Record Drawings"

**HERITAGE VILLAGE  
 OF PALM BEACH LAKES**

DEVELOPER: **BURG & DIVOSTA**  
 10358 RIVERSIDE DRIVE  
 PALM BEACH GARDENS, FL., 33410  
 PH. (305) 622-0652

LANDSCAPE ARCHITECT & PLANNERS  
**G.B.S.**  
 1080 E. INDIANTOWN ROAD  
 JUPITER FL, 33458  
 PH. (305) 747-6330

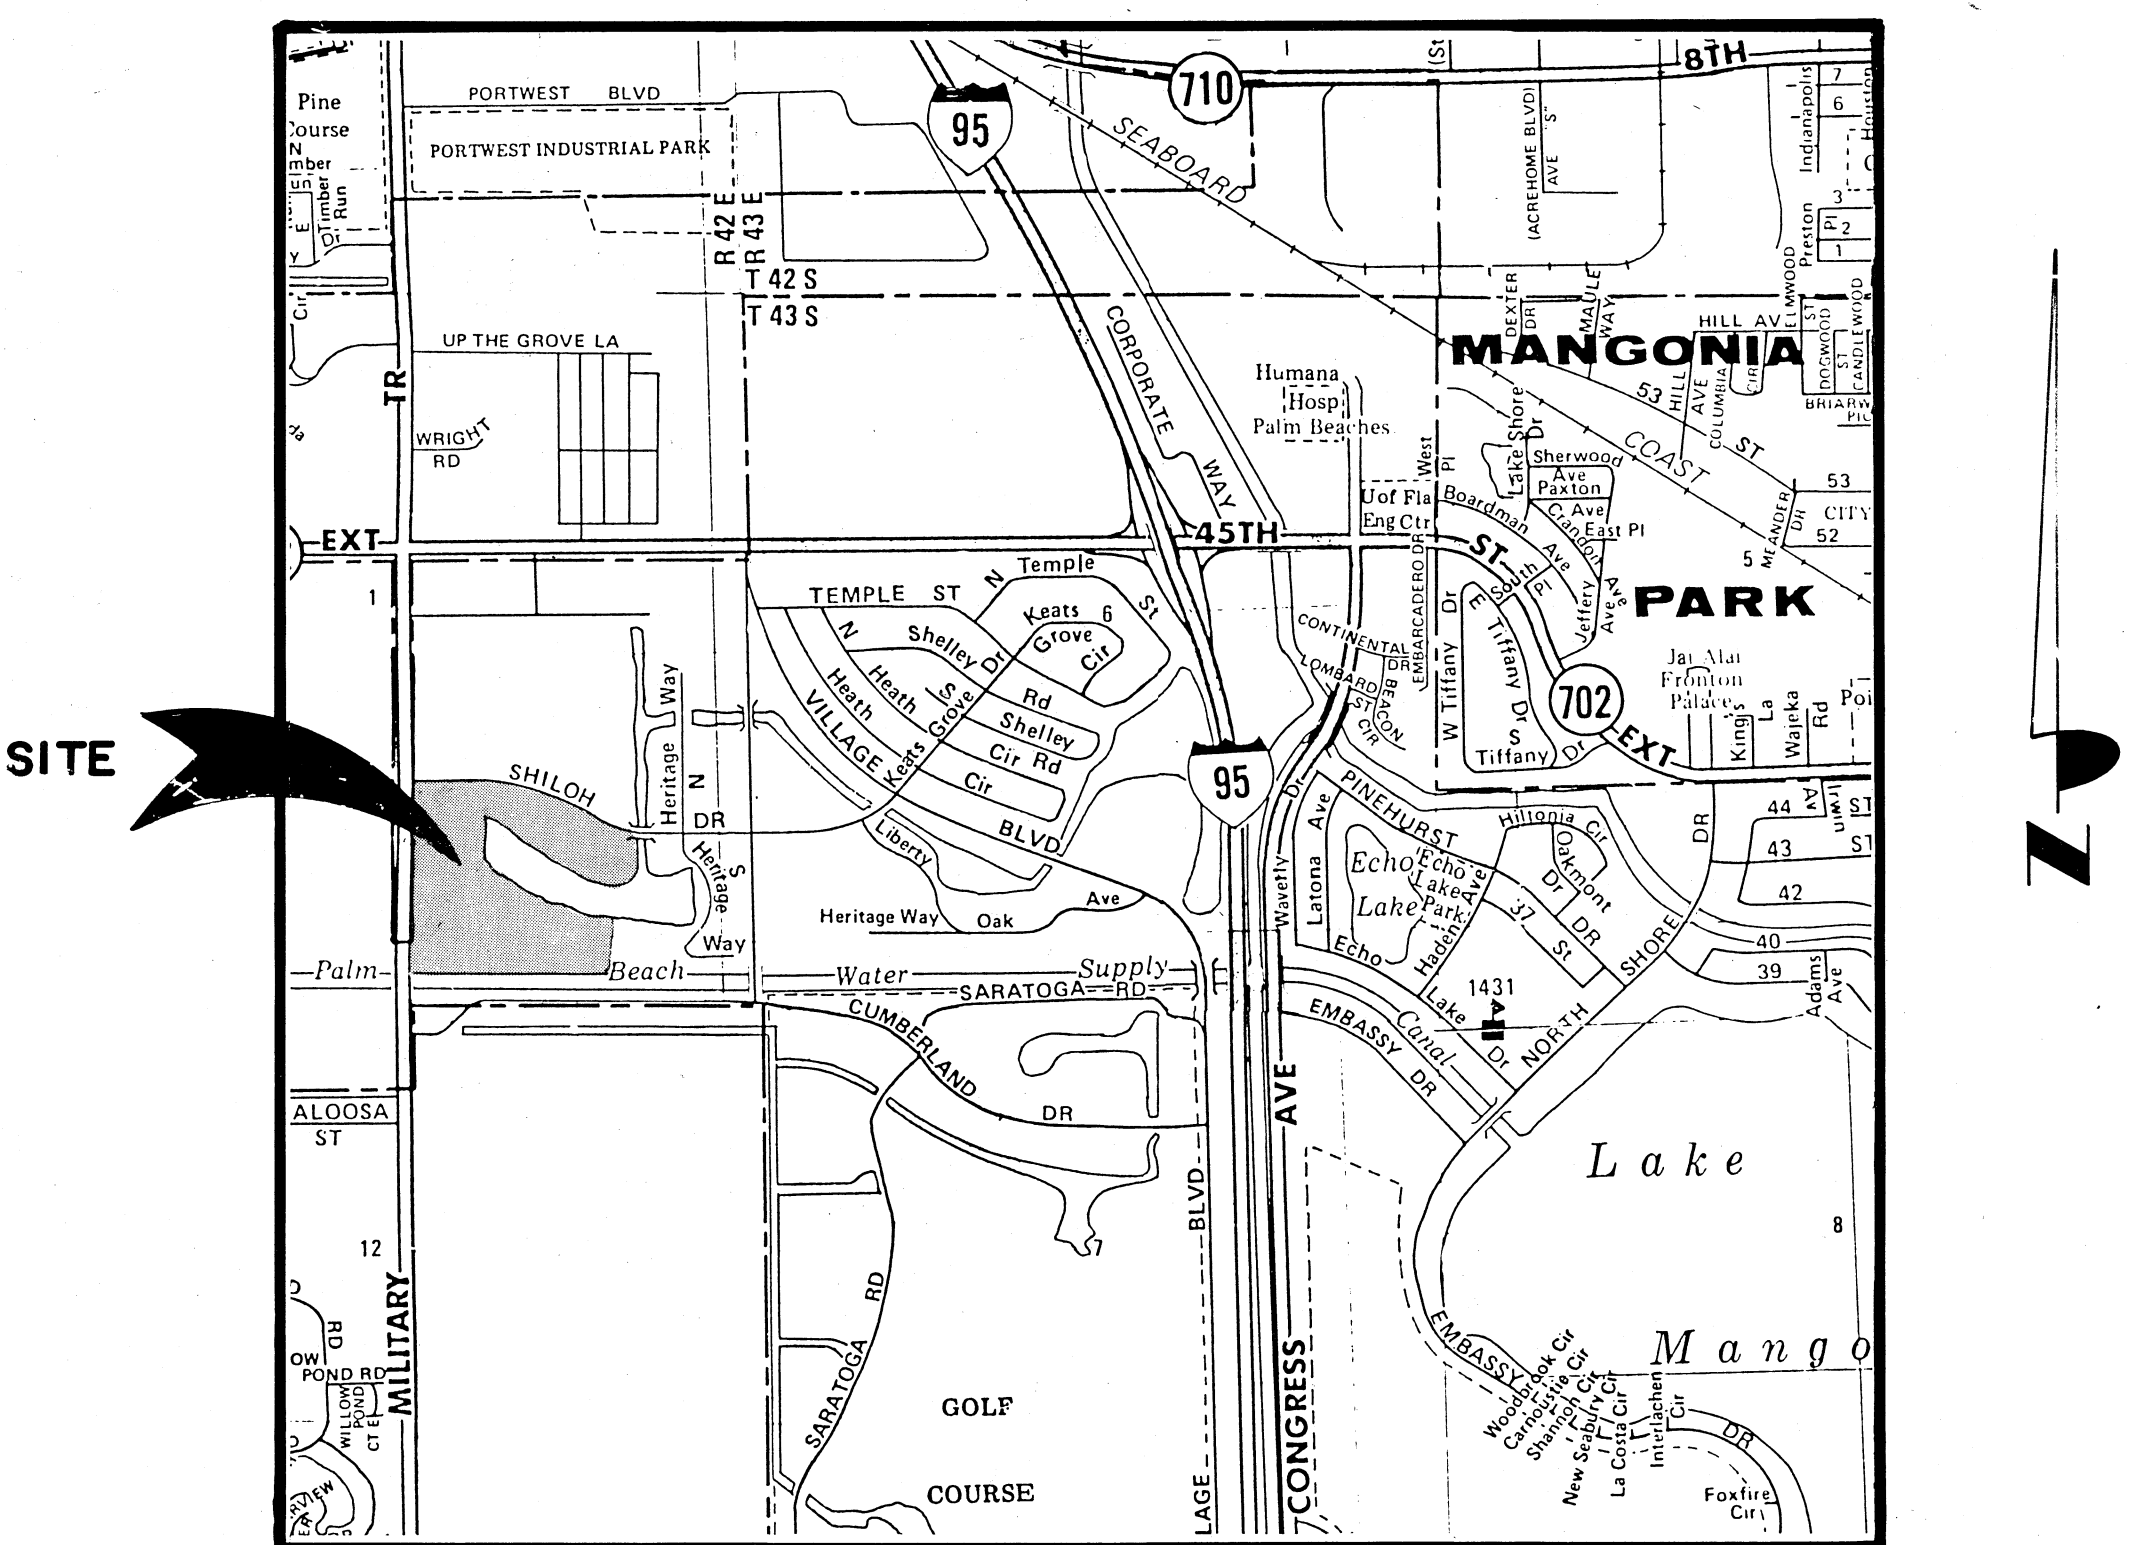

LOCATION MAP  
 N.T.S.  
 SEC. 1 TWP. 43S. RGE 42 E.

INDEX OF SHEETS

No.	DESCRIPTION
1	COVER SHEET
2	TRIBUTARY MAP
3-6	PAVING, GRADING & DRAINAGE PLAN
7-9	PAVING, GRADING & DRAINAGE DETAIL
10-13	WATER DISTRIBUTION & SANITARY SEWAGE COLLECTION PLAN
14-15	WATER DISTRIBUTION & SANITARY SEWAGE COLLECTION DETAILS
16-18	SANITARY SEWER PROFILES
○	SHEET INCLUDED IN THIS SET.

PREPARED BY:

**LAWSON, NOBLE & ASSOCIATES, INC.**  
 CONSULTING ENGINEERS · LAND PLANNERS · SURVEYORS  
 1501 CORPORATE DRIVE SUITE 150 BOYNTON BEACH, FLORIDA 33435  
 PH: (305) 736-9944