



NOTE: SEE TYPICAL PARKING LOT DETAIL SHEET 7 OF 18 FOR GRADING OF PARKING AREAS UNLESS OTHERWISE GRADED

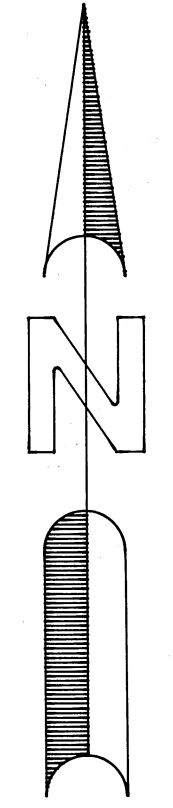

LEGEND

- EXISTING STORM SEWER WITH CATCH BASIN: - - - ST. - - - ST. - - -
- STORM SEWER LINE WITH JUNCTION BOX: —●—
- STORM SEWER LINE WITH CATCH BASIN: —■—
- SANITARY SEWER LINE WITH MANHOLE: - - - SAN - - - SAN - - -
- SEWAGE FORCE MAIN: - - - FM - - -
- WATERLINE: - - - W - - -
- PROPOSED ELEVATION: (16.56)
- EXISTING ELEVATION: (16.1)
- HIGH POINT: H.P.
- DIRECTION OF FLOW: —>—
- FINISHED FLOOR ELEVATION: FIN. FL. =
- STRUCTURE NUMBER: (00)
- GRATE/RIM ELEVATION: (00.00)
- F.L. ELEVATION: (00.00)
- EX. STRUCTURE NUMBER: (00)
- EX. GRATE/RIM ELEVATION: (00.00)
- EX. F.L. ELEVATION: (00.00)
- TYPICAL BUILDING No. (1)

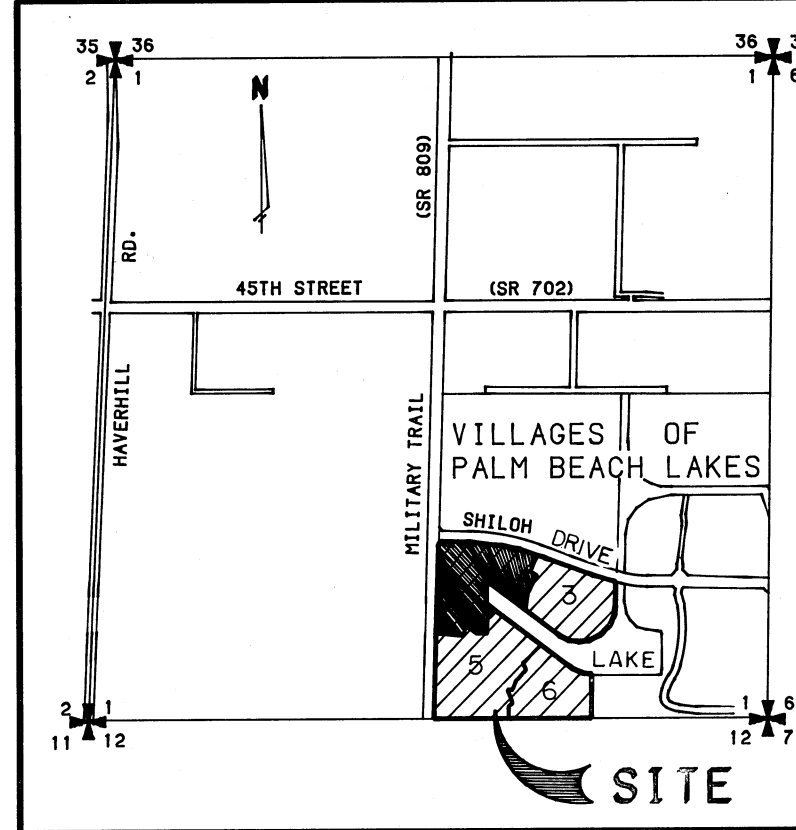

LOCATION MAP SECTION 1-43S-42E

REVISIONS	DATE	BY	CK'D
Rev. Drainage Inverts	11/16/86 MK		
As-Built	1/19/87 MK		
Rev. & Grading	2/25/87 MK		
Rev. Sidewalk Per. Cont.	8/11/87 KC		

SCALE: 1"=40'
 DATE: SEPT. 1986
 BY: R.A.C.
 CK'D: [Signature]
 F.B. PG.
 JOB NO: 86-168

LAWSON, NOBLE & ASSOCIATES, INC.
 ENGINEERS PLANNERS TESTING SURVEYORS
 1501 CORPORATE DRIVE SUITE 150
 BOYNTON BEACH, FLORIDA 33435 PH: (305) 736-9944

