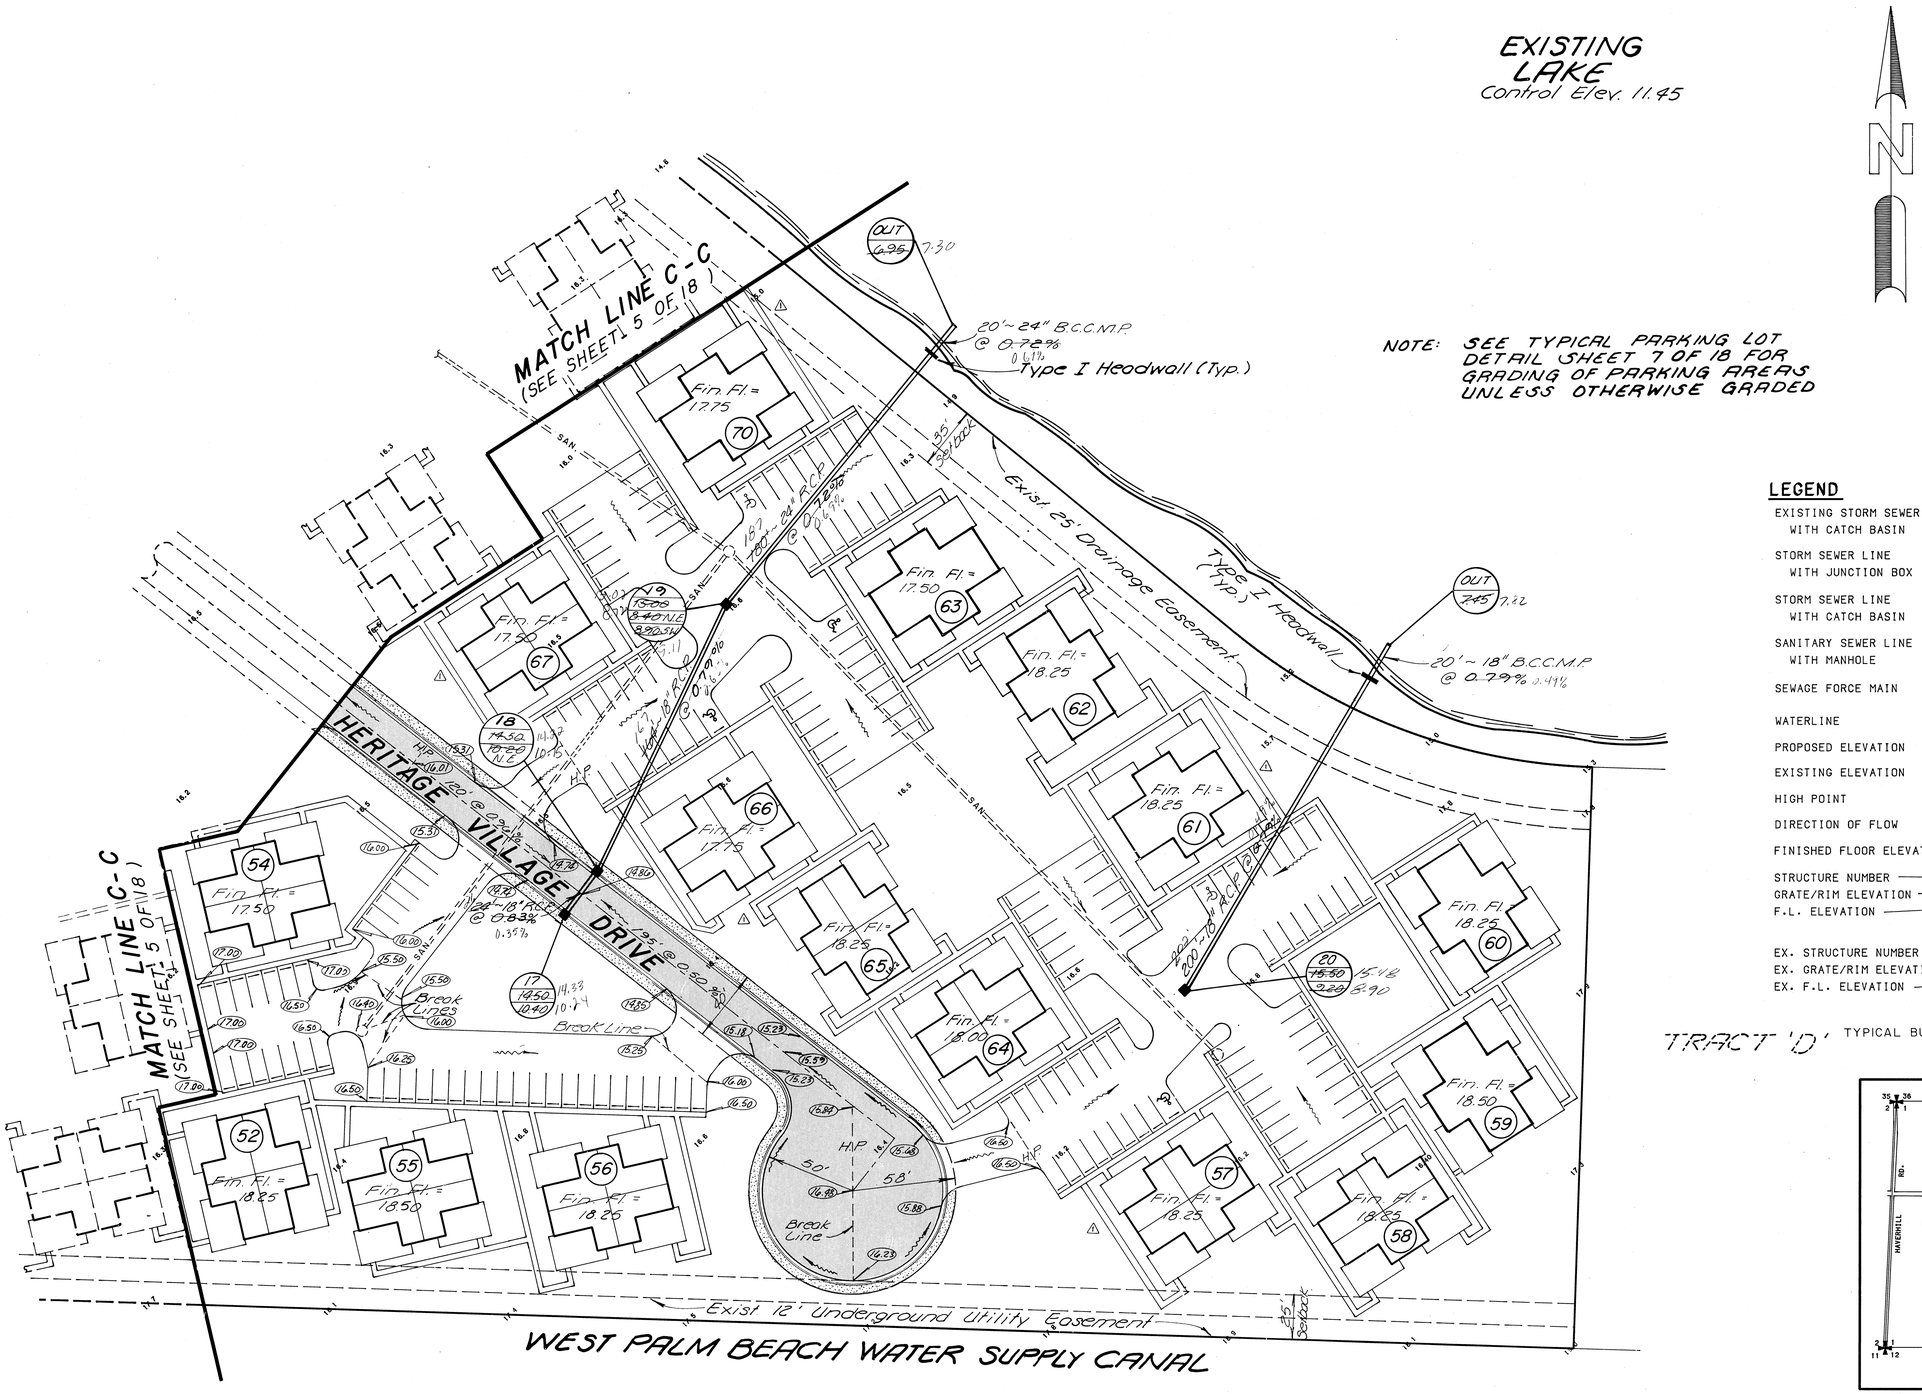

NOTE: SEE TYPICAL PARKING LOT DETAIL SHEET 7 OF 18 FOR GRADING OF PARKING AREAS UNLESS OTHERWISE GRADED

LEGEND

EXISTING STORM SEWER WITH CATCH BASIN	ST. ST.
STORM SEWER LINE WITH JUNCTION BOX	
STORM SEWER LINE WITH CATCH BASIN	
SANITARY SEWER LINE WITH MANHOLE	SAN SAN
SEWAGE FORCE MAIN	FM
WATERLINE	W
PROPOSED ELEVATION	16.56
EXISTING ELEVATION	16.11
HIGH POINT	H P
DIRECTION OF FLOW	
FINISHED FLOOR ELEVATION	FIN. FL. =
STRUCTURE NUMBER	00
GRATE/RIM ELEVATION	00.00
F.L. ELEVATION	00.00
	00.00
EX. STRUCTURE NUMBER	00
EX. GRATE/RIM ELEVATION	00.00
EX. F.L. ELEVATION	00.00
	00.00

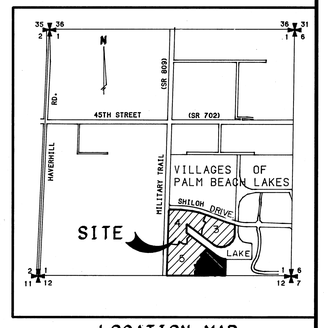

LOCATION MAP
SECTION 1-43S-42E

Z06F16804
SHEET 6 OF 18

FILE NO. 86-168

PAVING, GRADING, AND DRAINAGE PLAN
FOR
HERITAGE VILLAGE

REVISIONS	DATE	BY	CK'D
Rev. Drainage Inverts	9/16/86	M.K.	
As-Builts	1/19/87		
Rev. Sidewalk Per Client	3/11/87	R.C.	

SCALE: 1"=40'
DATE: SEPT. 1986
BY: R.A.C.
CK'D:
F.B. PG.
JOB NO: 86-168

LAWSON, NOBLE & ASSOCIATES, INC.
ENGINEERS PLANNERS TESTING SURVEYORS
1501 CORPORATE DRIVE SUITE 150
BOYNTON BEACH, FLORIDA 33435 PH: (305) 736-9944